


FEB. 10, 1936, PLAN OF PARTS
OF TOWER ROAD AND RICHARD ROAD
BY: JOHN T. COSGROVE, TOWN ENGINEER

PLAN
SCALE: 1IN=40FT

- LEGEND:
- BIT. BITUMINOUS
 - CB CATCH BASIN
 - CONC. CONCRETE
 - DMH DRAIN MANHOLE
 - GG GAS GATE
 - GRAN. GRANITE
 - INV. INVERT
 - RET. RETAINING WALL
 - SMH SEWER MANHOLE
 - SW SIDEWALK
 - WG WATER GATE
 - PVC POLYVINYL CHLORIDE
 - VERT. VERTICAL


REFERENCE:
MIDDLESEX COUNTY REGISTRY OF DEEDS,
SOUTH DISTRICT.
DEED BK. 32769, PG. 308
PL. NO. 91 OF 1933
PL. NO. 299 OF 1931

- NOTES:
- 1.) TOPOGRAPHY WAS OBTAINED BY THE EDM/PRISM POLE METHOD.
 - 2.) BENCH MARK USED:
54H MAGS DISK IN CONCRETE MONUMENT IN FRONT OF 1083 MASS. AVE. ELEV.=206.514
 - 3.) NOT ALL UNDERGROUND UTILITIES ARE SHOWN. BEFORE DESIGN AND CONSTRUCTION CALL "DIG SAFE" 1-888-344-7233.
 - 4.) THE PROPERTY IS LOCATED IN A RESIDENTIAL DISTRICT (RS).

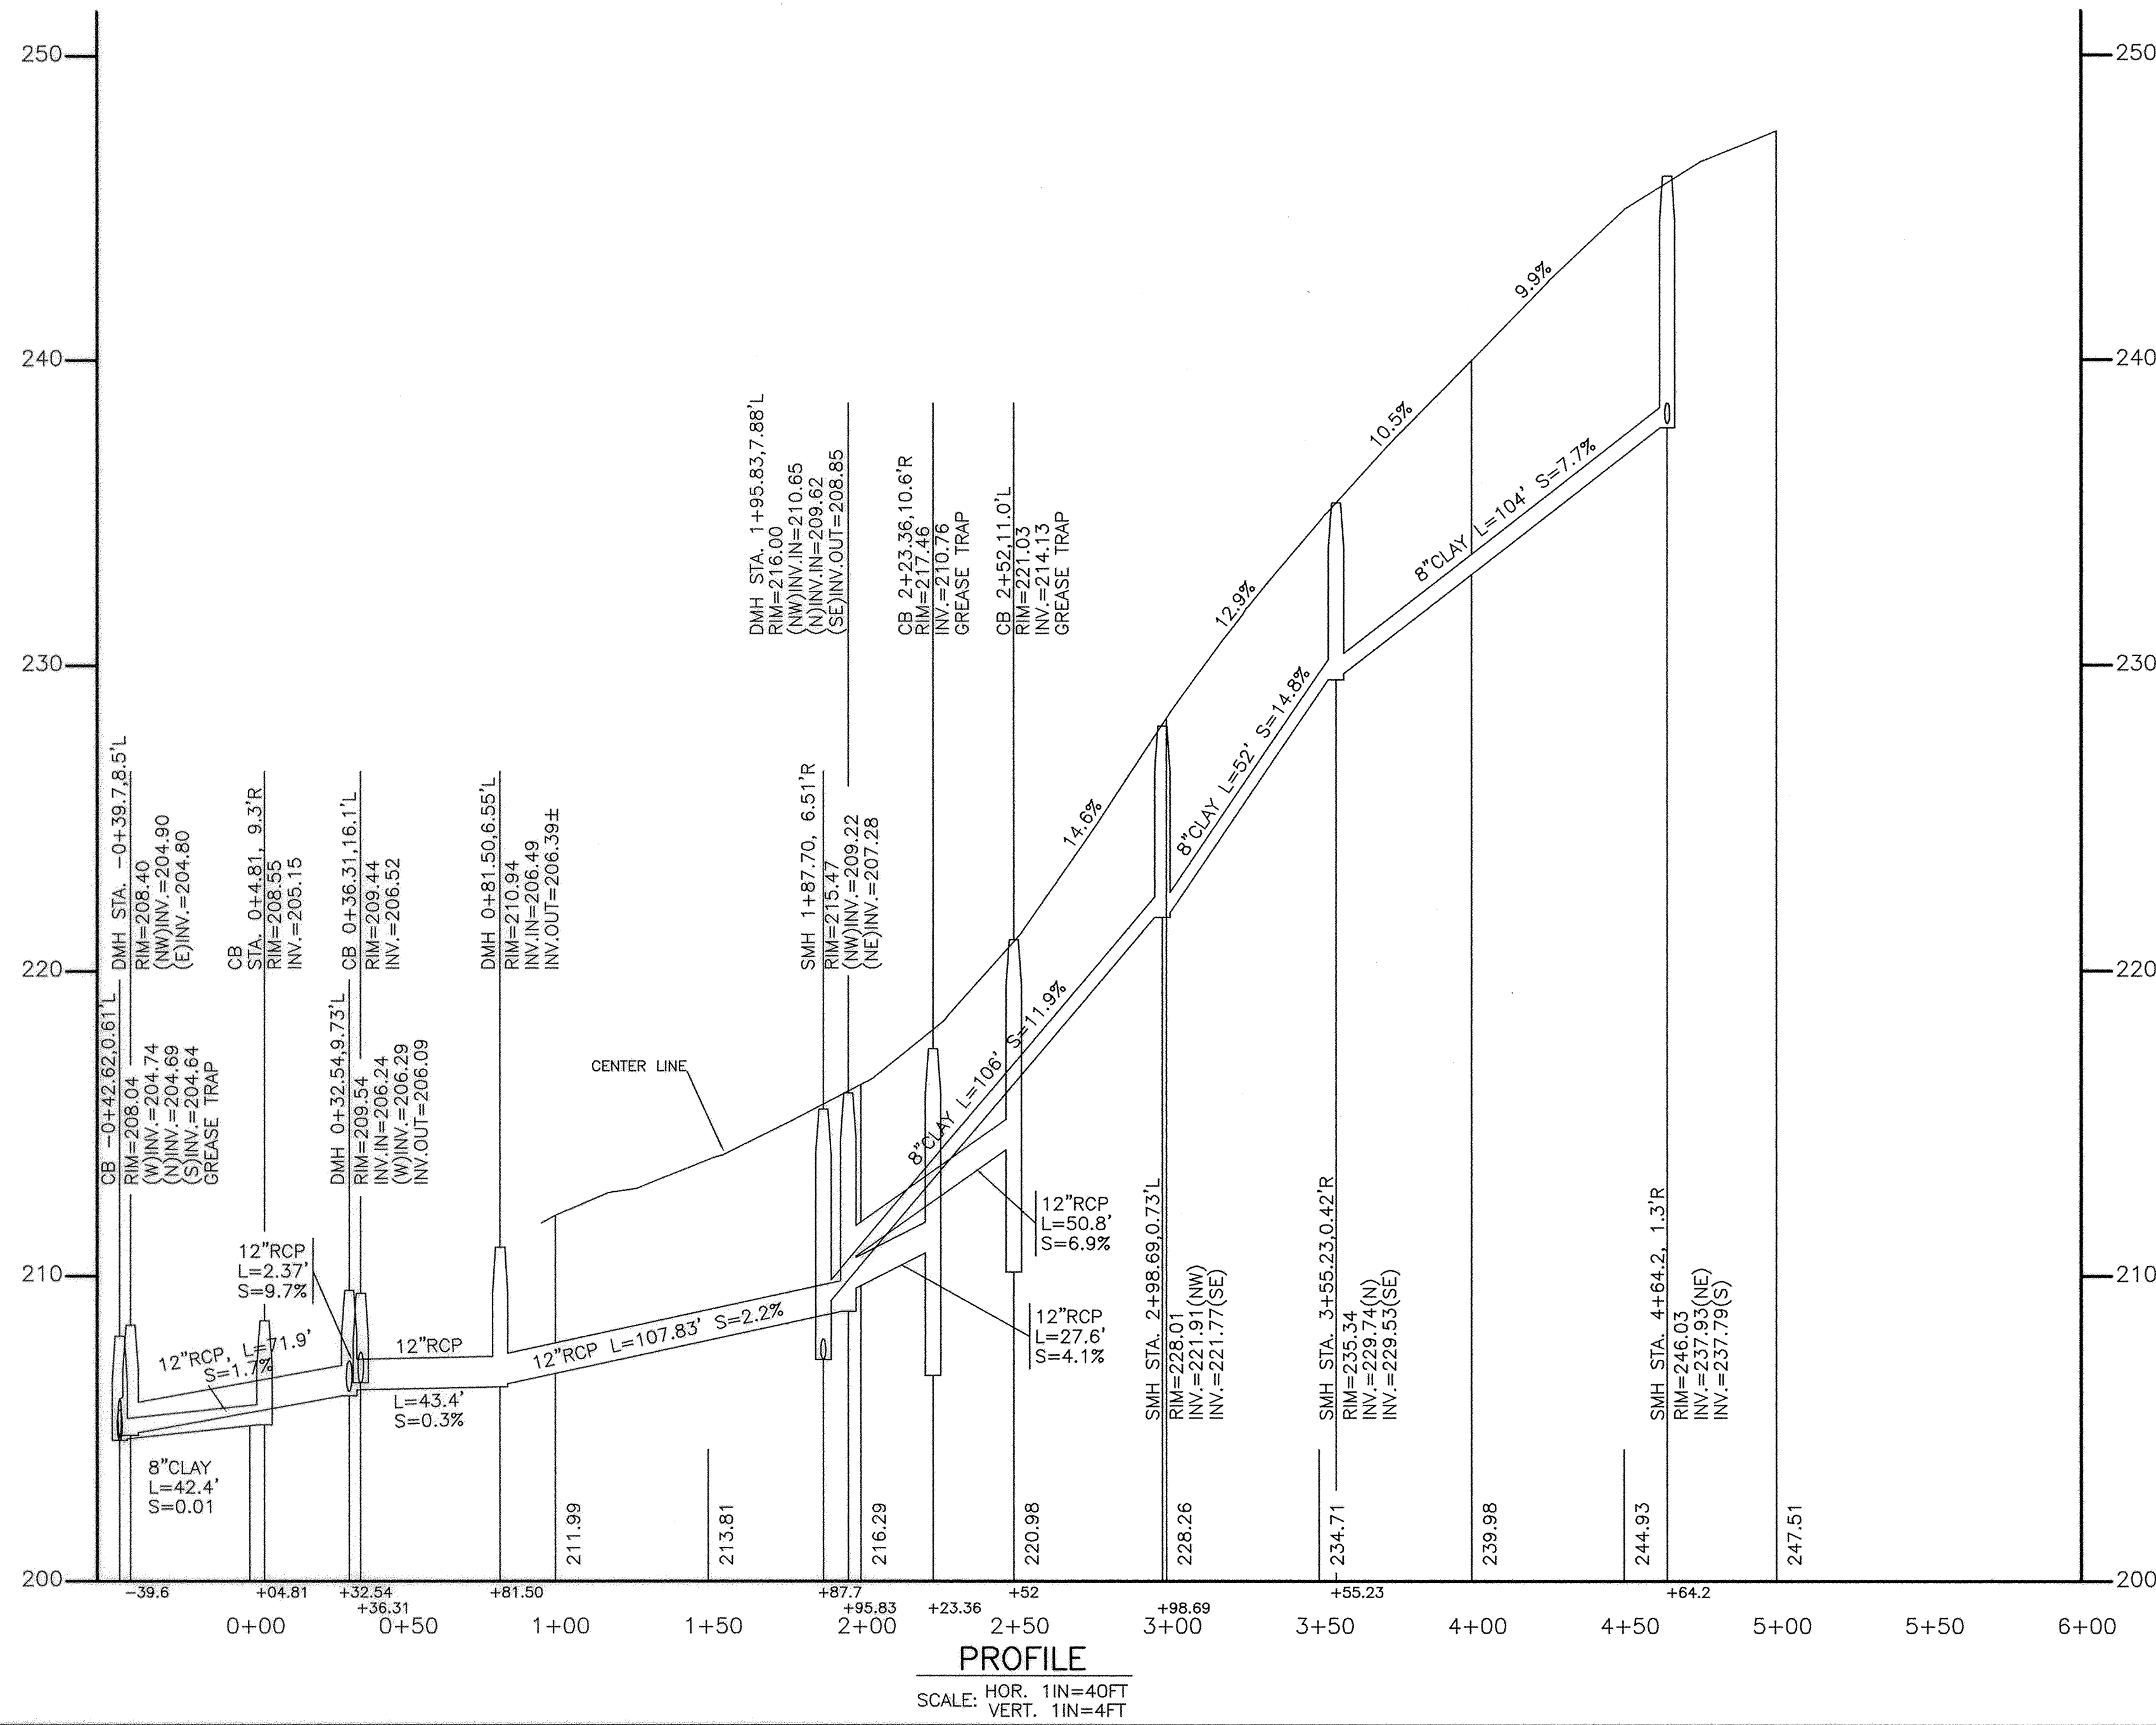


PROFILE
SCALE: HOR. 1IN=40FT
VERT. 1IN=4FT

APPLICANT & OWNER:
KEVIN MCIVER
329 MASS. AVE., STE. 1B
LEXINGTON, MA. 02420

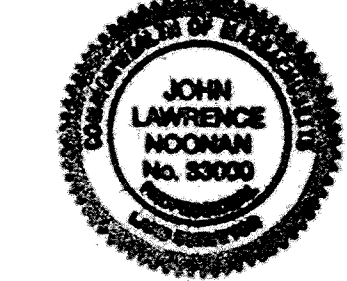

DEFINITIVE UNACCEPTED
STREET DEVELOPMENT IN
LEXINGTON, MASS.

AS BUILT PLAN PROFILE
TOWER ROAD STA. 0+00 TO 5+42.67

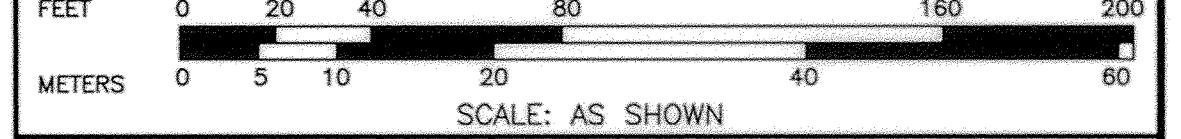

SCALE: AS SHOWN
NOONAN & MC DOWELL, INC.
SUITE 6, 25 BRIDGE STREET
BILLERICA, MASS., 01821-1023

APRIL 1, 2003 JOB NO. 1764/006 SHEET NO. 1 OF 1

DWG. NO. 1764AB

5-7-03 *John Lawrence Noonan*